



PARDI WAY/BIG CUT RD./SACRAMENTO STREET WATERLINE REPLACEMENT PROJECT

CIP # 41109



CONSTRUCTION UPDATE

Week #5: October 31st – November 4th

Hi Everyone!

This is a weekly update to the community regarding the Pardi Way/Big Cut Rd./Sacramento Street Waterline Replacement Project. Construction began Monday, October 3rd, and these updates will be sent via email to interested parties and posted on the City of Placerville's website to keep the community informed as to the status of this project. Each update will involve a summary of work completed the prior week, work being performed the current week, work anticipated the following week, and any important information that may impact the community. Thanks in advance for everyone's understanding and patience through this process.

Prior Week

- Weather delayed construction as three days were rained out.
- When weather permitted, water main was installed on Gilmore.
- When weather permitted, water services were installed on Chamberlain.

Current Week

- Water main installation on Gilmore and Chamberlain.
- Water service installation on Chamberlain.
- Thursday evening begins night work on Sacramento Street (Highway 49).

Following Week

- Water service installation on Gilmore.
- Water main and service installation on Sacramento Street (Highway 49).

Important Information

- Portions of this project will be constructed during the day (7 am – 4 pm) and at night (7 pm – 5 am). Please be aware that there will be **road closures and detours** during **working hours**. Residents in the project area may experience delays due to construction but access to your property will be maintained at all times. Thank you for your understanding.
- Residents on **Sacramento Street**, please be aware that **Sacramento Street will be closed** during working hours (**7 pm – 5 am**) from **Pacific Street to Skyline Dr/Coon Hollow Rd** starting **November 3rd**.

Contacts



Jim Fisher, Resident Engineer	R.E.Y. Engineers	(916) 612-7581	jfisher@reyengineers.com
Ryan Ruddick, Inspector	R.E.Y. Engineers	(707) 391-7013	rruddick@reyengineers.com
Rebecca Neves, City Engineer	City of Placerville	(530) 642-5250	rneves@cityofplacerville.org

Thank you!


Placerville Waterline Replacement Project - CIP #41109



Site Map

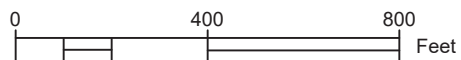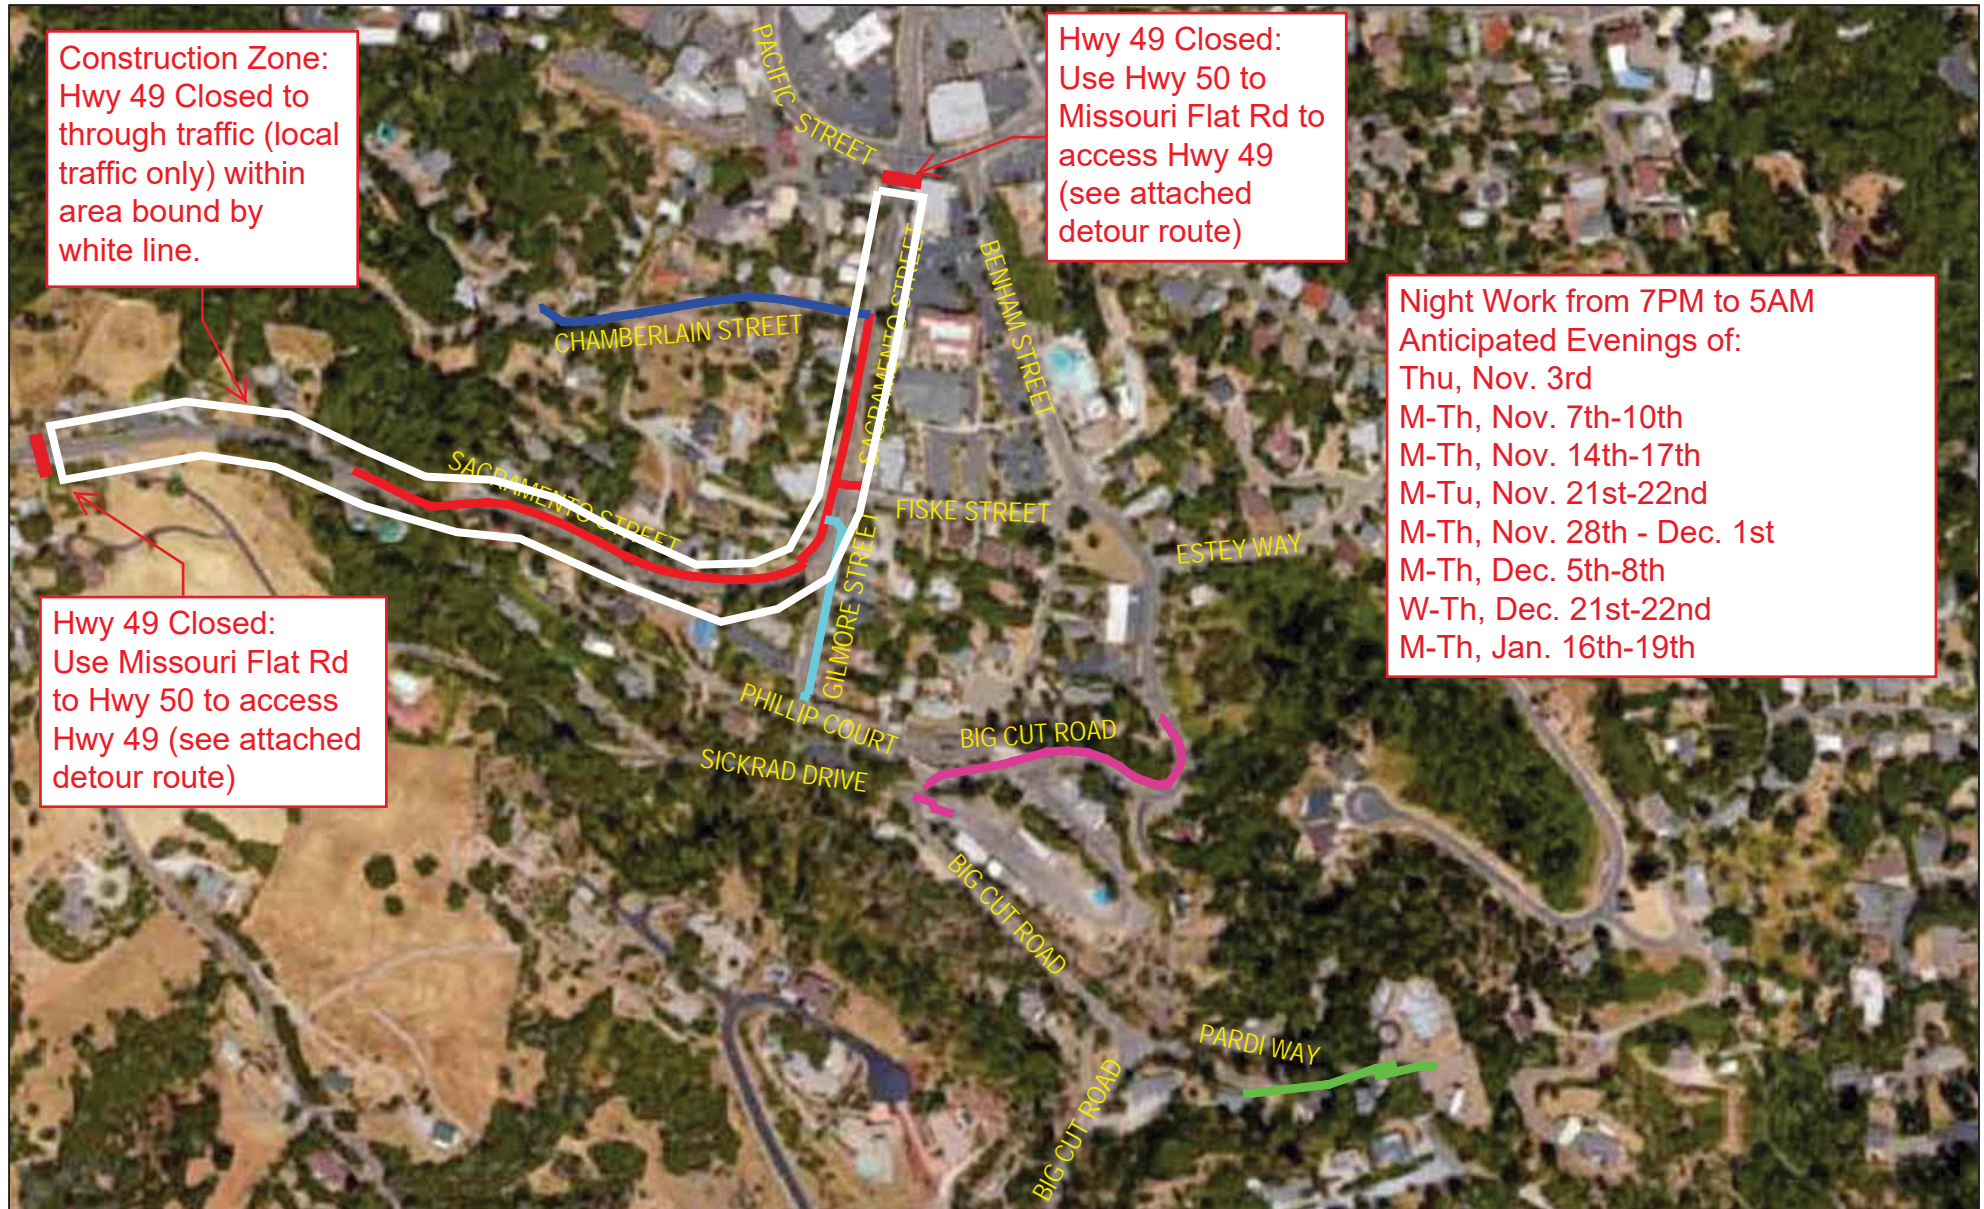

* All traffic devices to be installed and maintained per section 02060 of the ~~City of Placerville Standards~~
Project Specifications

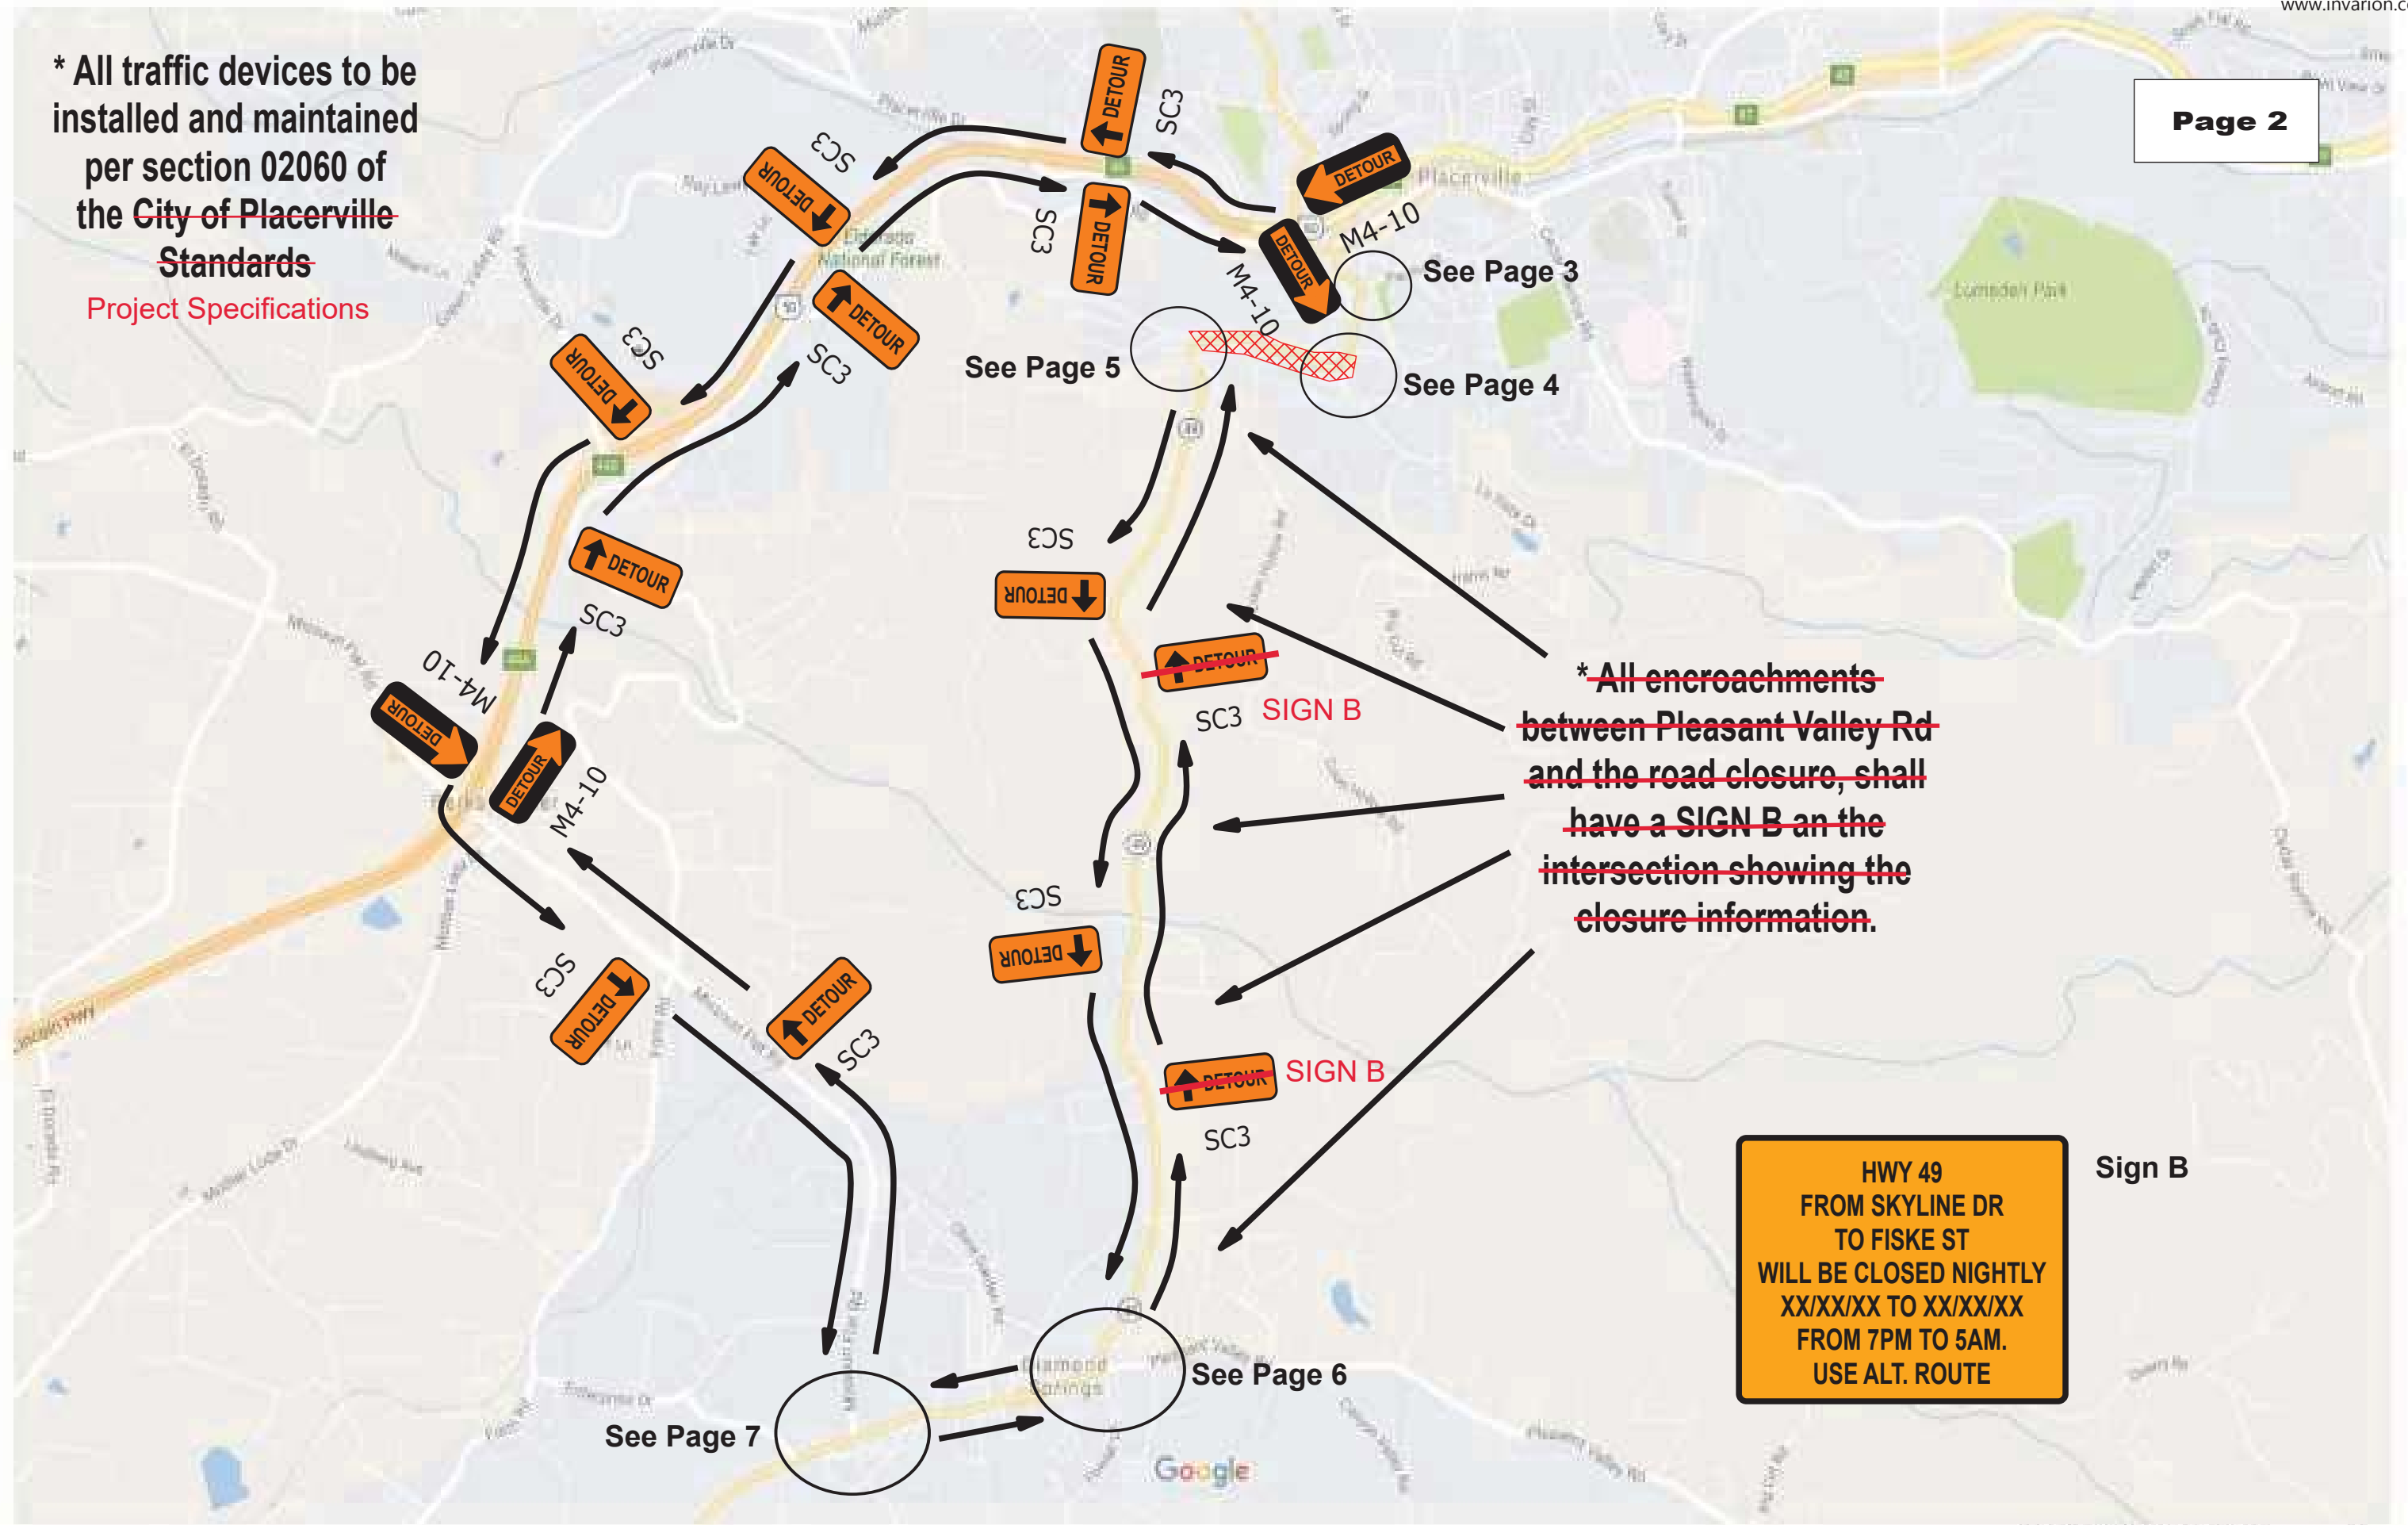

~~* All encroachments between Pleasant Valley Rd and the road closure, shall have a SIGN B at the intersection showing the closure information.~~

HWY 99
FROM SKYLINE DR
TO FISKE ST
WILL BE CLOSED NIGHTLY
XX/XX/XX TO XX/XX/XX
FROM 7PM TO 5AM.
USE ALT. ROUTE

Sign B